

THIS DRAWING IS UNPUBLISHED. RELEASED FOR PUBLICATION, 19

© COPYRIGHT 19 BY AMP INCORPORATED, HARRISBURG, PA. ALL INTERNATIONAL RIGHTS RESERVED. AMP PRODUCTS MAY BE COVERED BY U.S. AND FOREIGN PATENTS AND/OR PATENTS PENDING.


REVISIONS						
P	F	ZONE	LTR	DESCRIPTION	DATE	APPROVED
✓	✓		E	REDRAWN-REV. PER G-1477, G-1177, P85-0055 & P85-0056	12-18-85	Pjm
✓	✓		F	OBS. 2--3 REV. PER G-3358	4-25-88	me/ GY
✓	✓		G	REV PER G-4732	JT 7-22-88	JT
✓	✓		H	OBSOLETE 2--2 PER G-3780	JT 10/14/88	FGJ
✓	✓		J	REV PER G-5411	2/24/90	DKS/ajs
✓			K	REV/0720-0032-93	LO 2/93	me

D

C

B

A

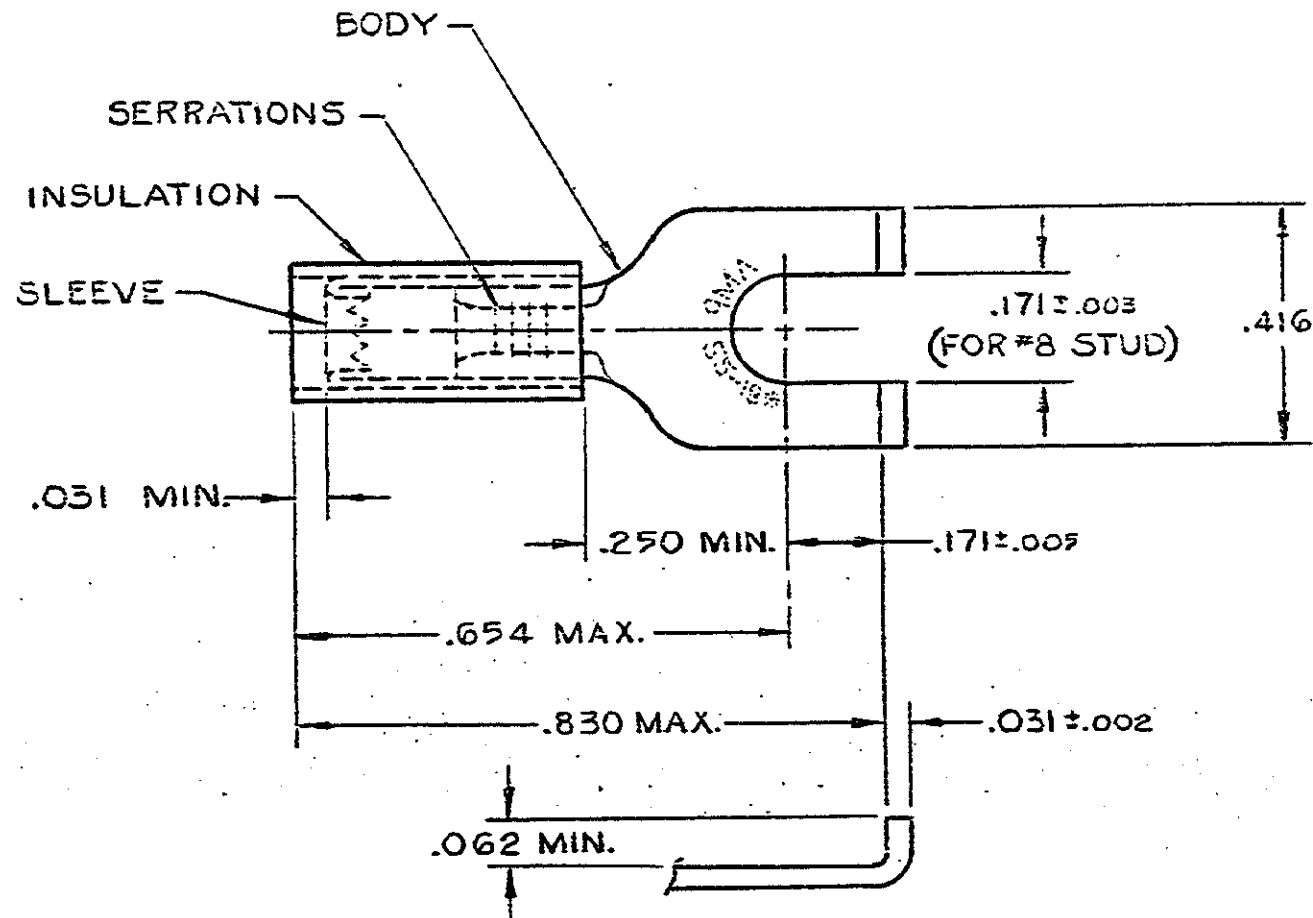

WIRE INSULATION DIA. = .105-.140

22-13 MARKING FOR MILITARY COMMERCIAL RANGE 22-16

TIN PLATE (MIL-T-10727)

OBSOLETE  
OBSOLETE

100	LOOSE PC, BOX	8-32498-1
<del>100</del>	<del>ON TAPE, SM. BOX</del>	<del>2-32498-3</del>
<del>1000</del>	<del>ON TAPE, LS BOX</del>	<del>2-32498-2</del>
5000	ON TAPE, REEL	2-32498-1
<del>#</del>	LOOSE PIECE	32498
QUANTITY	DESCRIPTION	PART NO

UNLESS OTHERWISE SPECIFIED DIMENSIONS ARE IN INCHES. TOLERANCES ON: DECIMALS ±.008 ANGLES ± 90	CONTRACT NO	AMP INCORPORATED Harrisburg, Pa.	
	DR UTA IRFB 9-19-85		
MATERIAL INSULATION: NYLON - RED BODY & SLEEVE: COPPER (QQ-C-576)	CHK <i>P. Muty changed 11/15/85</i>	NAME WIRE TERMINAL P.I.D.G. FLANGED SPADE WIRE SIZE: 22-16	
	APPD <i>M. Smith 11-15-85</i>	SIZE <b>B</b>	FSCM NO 00779
FINISH BODY-SEE NOTE	OTHER APPD	DRAWING NO 32498	SCALE NTS
		SHEET 1 OF 1	